


NOTE:

- 1 CONTRACTOR SHALL CHOKE QUARRY SPALLS WITHIN ACCESS RAMP WITH 3/4\"/>


LEACHATE LAGOON
ACCESS RAMP
DETAIL
NTS
4, 5, 14

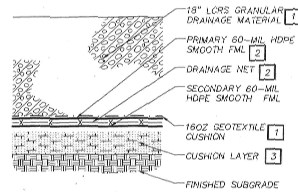

NOTES:

- 1 LORS GRANULAR DRAINAGE MATERIAL AND GEOTEXTILE CUSHION LAYER SHALL BE PLACED ONLY ON THE BOTTOM OF THE LAGOON EXCEPT FOR ACCESS RAMP, SEE DETAIL 1.
- 2 BENEATH THE ACCESS RAMP, INSTALL TEXTURED FML FOR THE PRIMARY AND SECONDARY LAYER AND SUBSTITUTE DRAINAGE NET WITH GEOCOMPOSITE (SLOPE), SEE SHEET 4.
- 3 CUSHION LAYER THICKNESS AS NECESSARY TO MEET SECTION 02232 OF THE SPECIFICATIONS.

LEACHATE LAGOON
LINER SYSTEM
DETAIL
NTS
6
4, 6

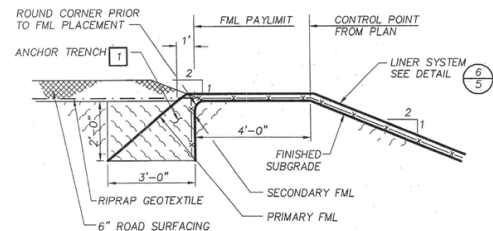


NOTE:

- 1 CONTRACTOR SHALL NOT BACKFILL ANCHOR TRENCH UNTIL THE FML HAS HAD TIME TO EXPAND AND CONTRACT INTO ITS FINAL POSITION.

LEACHATE LAGOON
ANCHOR TRENCH
DETAIL

As - Built Details of Leachate Lagoon (Parametrix, Inc.)
FOR REFERENCE ONLY

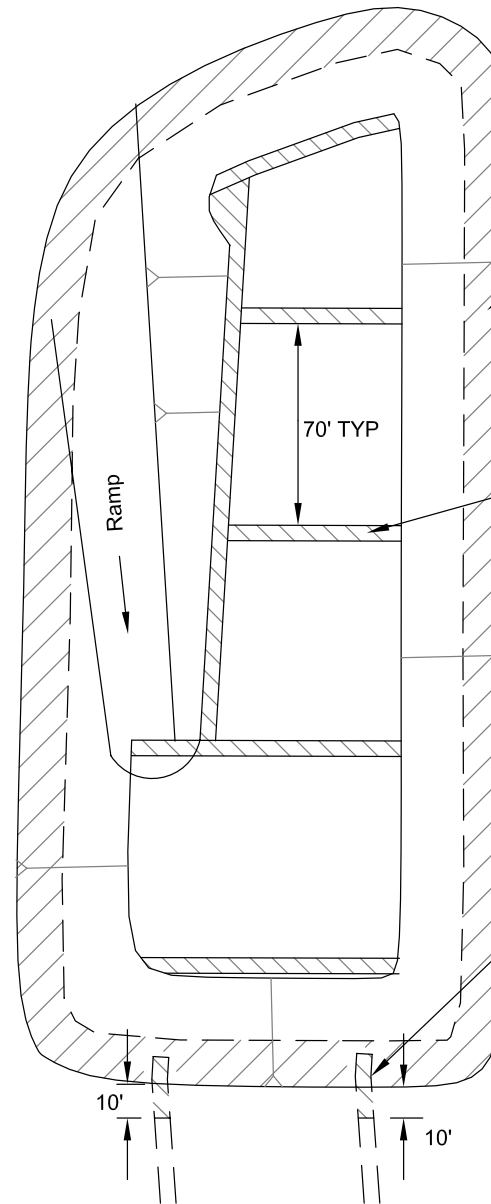

Note: See details this sheet for As Built information on leachate lagoon liner system.

Remove All Liner Materials from Anchor Trench down to Minimum 8' Below Surrounding Grade

Trench Through and Remove All Liner Materials from 5' Wide Strip - Typ.

Remove Pipes to Min. 10' Beyond Top of Slope, Typ. of 2 Places.

Scale 1" = 20'

No.	Revised	By	Date
1	Addenda 1,2,3	GM	8/10/06
A-Mehr, Inc. <small>2319 MC Cook Dr. Laguna Hills, CA 92653 (949) 266-0157</small>			
Central Maul Landfill Phase IV-B Part 1&2 Construction Plans Leachate Lagoon Demolition Plan			
FILED/NAME			Maud ph IVB
DRAWN			GM
CHECKED			
DATE			7/27/06
FIGURE			
			17

Central Maui Landfill

Phase IV–A Modifications

Prepared by:

A-Mehr, Inc.
 23016 Mill Creek Drive
 Laguna Hills, CA 92653
 (949) 206-0157
 9/1/04


This work was prepared by me
 Or under My Supervision

Project Engineer

Ali Mehrazarin, PE

_____ date


Sheet Number	Sheet Title
1	Key Map
2	Liner Inspection and Repair
3	Rain Flap Installation
4	Additional Operations Layer & Settlement Monuments
5	Stormwater Improvements
6	Leachate Manhole Modifications
7	Leachate Storage Tank Installation
8	Leachate Storage and Transfer Piping
9	Electrical Scope of Work

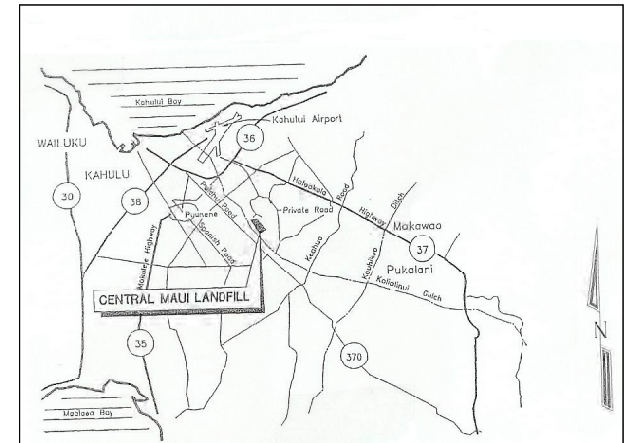


Vicinity Map

Owner:



County of Maui
 Department of Public Works
 200 South High Street
 Wailuku, Hawaii 96703

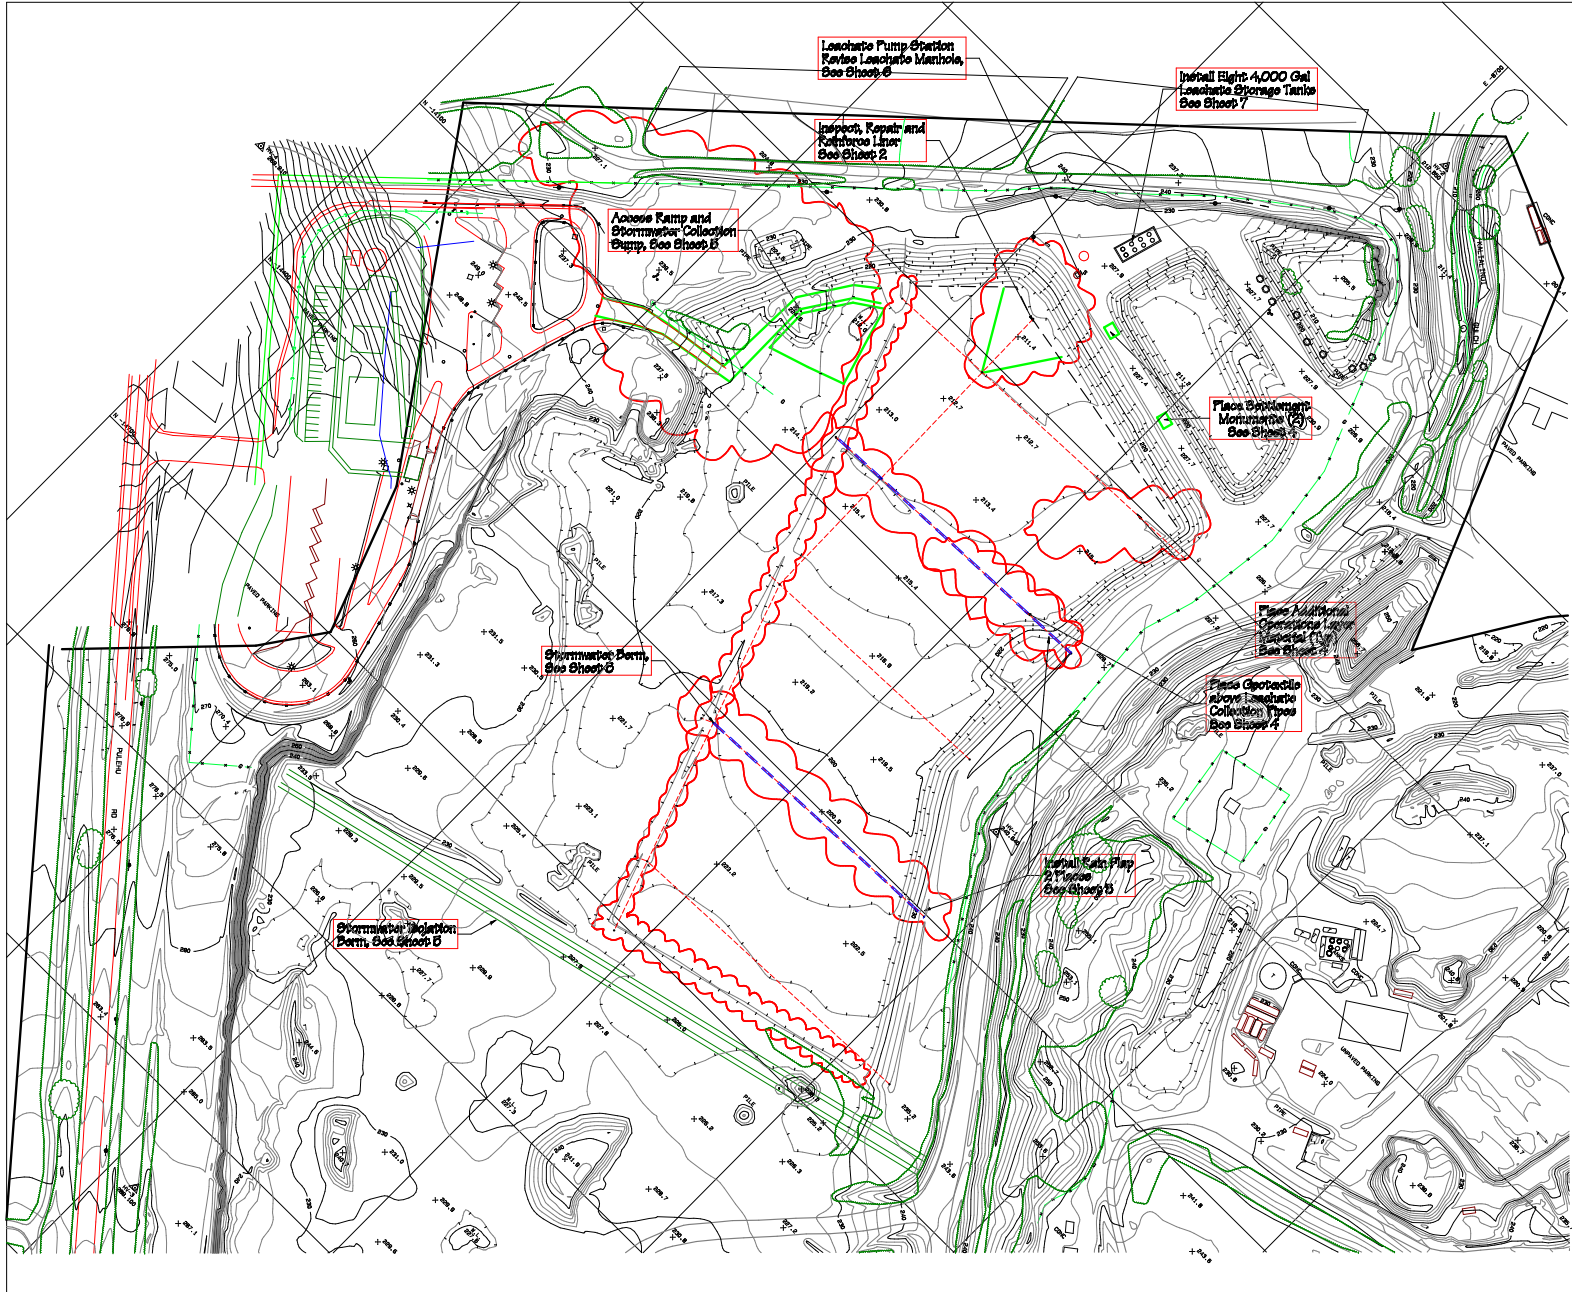


- Notes**
- (1) Existing Topography Based on Aerial Survey By Walker & Associates Dated 2/16/03
 - (2) Landfill Design Features Based on Drawings By Parametrix, Inc. Revised 7/8/98, Locations to be field verified.

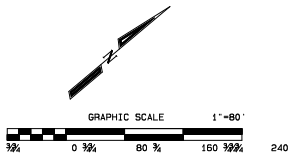

<h2 style="margin: 0;">A-Mehr, Inc.</h2> <p style="font-size: small; margin: 0;">Central Metal Landfill Phase IV-A Modifications</p> <p style="margin: 0;">Key Map</p>	PLAN/DATE
	ISSUED BY
	CHECKED
	DATE
	1

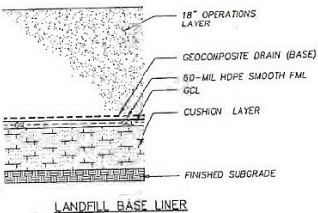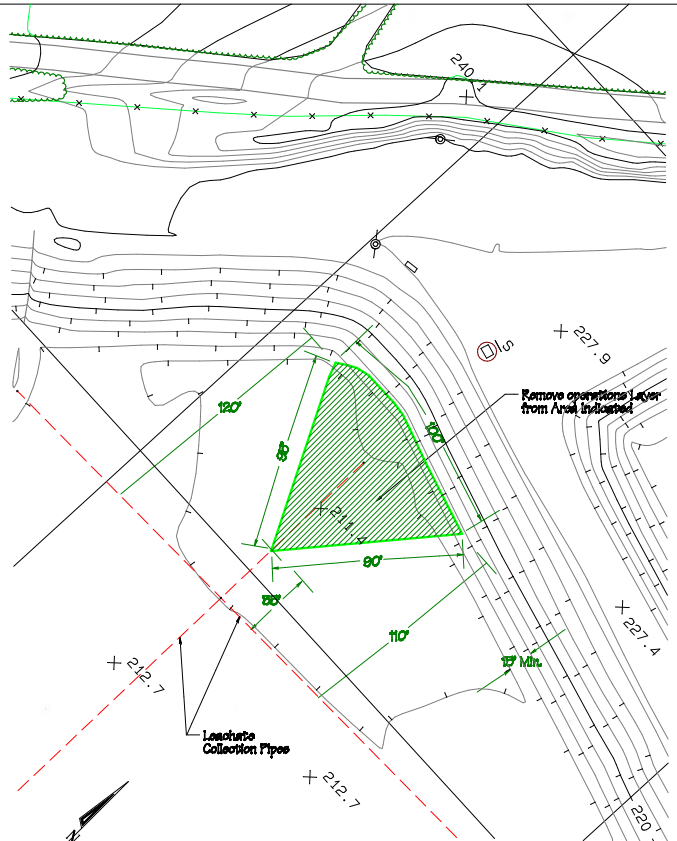


Existing Liner Details (Ref.)
(Not to Scale)

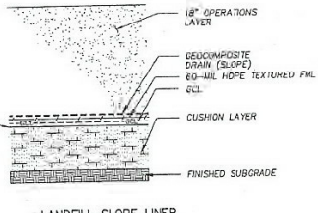


LANDFILL SLOPE LINER

INSPECTION AND REPAIR PROCEDURES

- (1) Remove existing 18" operations layer material from area shown (approximately 8,000 sq. ft.) per specifications.
- (2) Remove LCRS drainage material from around leachate collection pipe.
- (3) Remove geocomposite drainage material.
- (4) Inspect and test HDPE liner, repair defects per specifications.
- (5) Install overlay HDPE liner and geotextile per specifications and detail this sheet.
- (6) Install 12" granular drainage material on floor per detail this sheet and additional drainage material above leachate pipe per original configuration.
- (7) Cover granular drainage material with geotextile.
- (8) Install minimum 24 inch operations layer material.

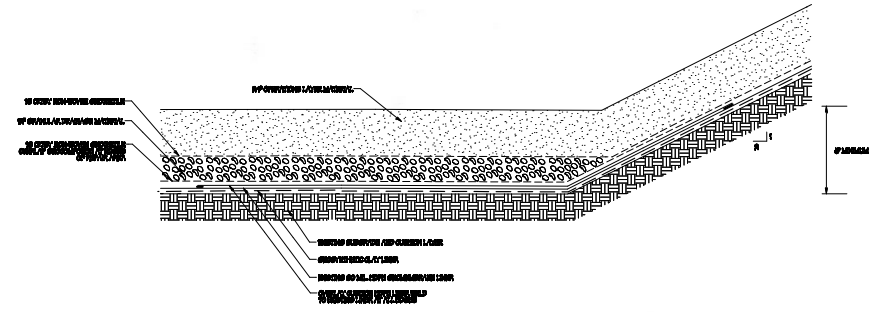

Base & Slope Liner after Inspection & Repair
(Not to Scale)

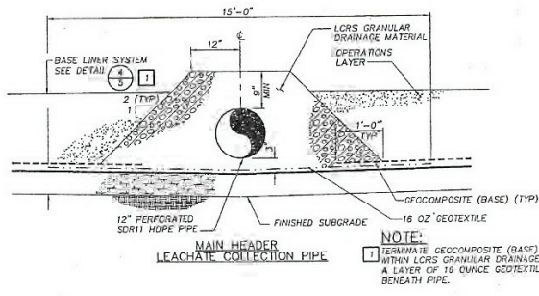


Existing Leachate Collection Pipe (Ref.)
(Not to Scale)

Notes



- (1) Existing Topography Based on Aerial Survey By Walker & Associates Dated 2/16/08
- (2) Landfill Design Features Based on Drawings By Parametrix, Inc. Revised 7/8/98. Locations to be field verified.

A-Mehr, Inc.		PROJECT DATE
Central Metal Landfill		DATE 02/04/08
Phase IV-A Modifications Liner Inspection and Repair		DATE 02/04/08
		2

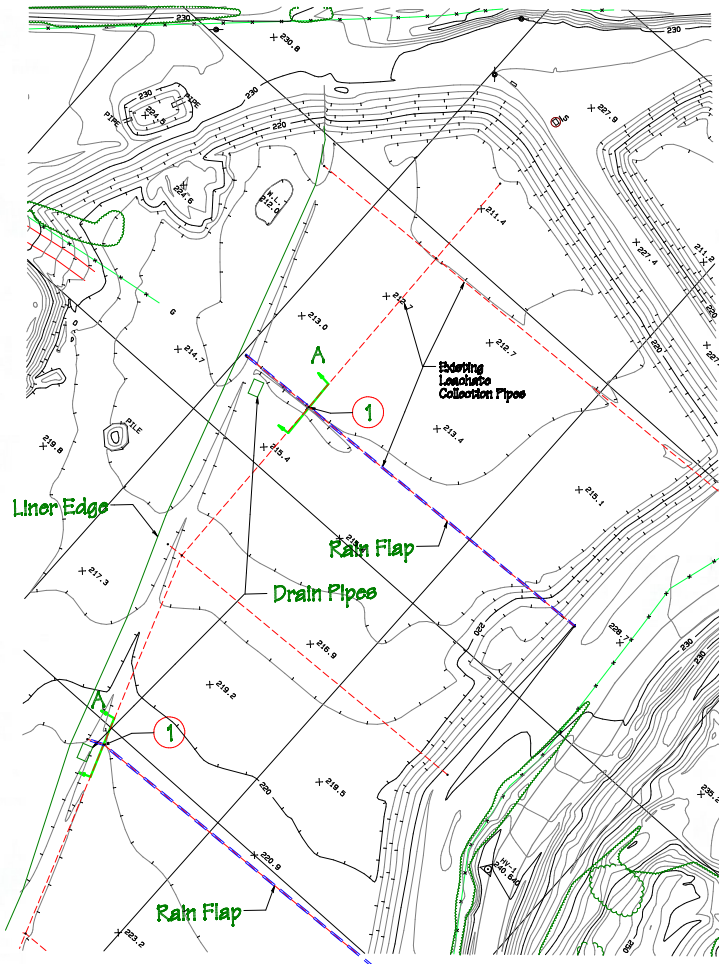


RAIN FLAP INSTALLATION

- (1) Remove existing operations layer material for 3 ft distance on downslope side of LCRS gravel wedge.
- (2) Cut Geocomposite along line of gravel wedge and lay back.
- (3) Remove section of main LCRS pipe per detail this sheet.
- (4) Place additional operations Layer material on downslope side of LCRS gravel wedge.
- (5) Weld HDPE flap to HDPE liner & cover over top of additional operations Layer material.
- (6) Lay Geocomposite back over rain flap.
- (7) Install additional operations layer material on upslope side of LCRS gravel wedge to form surface meter drainage path to next perimeter of cell.

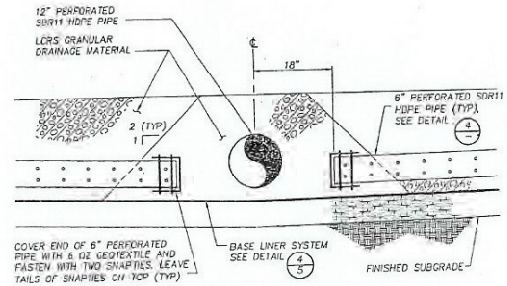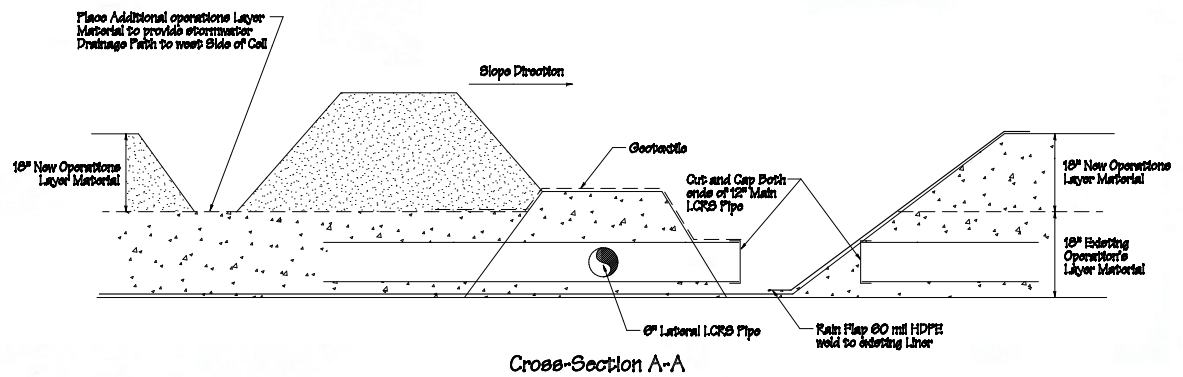

Existing Connection of Lateral Pipe to 12" Main Pipe (Ref.)
(Not to Scale)

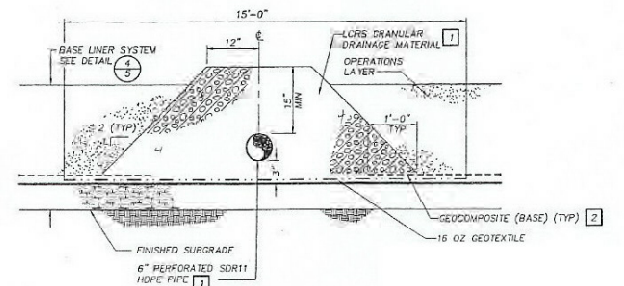

Existing Lateral Leachate Pipe (Ref.)
(Not to Scale)

- NOTE:**
- 1 AT THE TIE OF THE SLOPE, TRANSITION FROM 6" PERFORATED HDPE PIPE TO 6" SOLID WALL HDPE PIPE AND SUBSTITUTE LCRS GRANULAR DRAINAGE MATERIAL WITH OPERATIONS LAYER FOR THE SIDE SLOPES.
 - 2 TERMINAL SLOUM-POINTS (BASE) 1 FOOT EACH SIDE WITHIN LCRS GRANULAR DRAINAGE MATERIAL AND ADD A LAYER OF 16 OUNCE GEOTEXTILE CENTERED BENEATH PIPE.

- Notes**
- (1) Existing Topography Based on Aerial Survey By Walker & Associates Dated 2/18/08
 - (2) Landfill Design features Based on Drawings By Parametric, Inc. Revised 7/8/98, Locations to be field verified.

No.	Revision	Date	By
1	As-Built: Rain Flap Installation	10/19/04	KM

A-Mehr Inc.
Central Mud Landfill
Phase IV-A Modifications
Rain Flap Inspection

